

### LABOR AND MATERIALS


Copper } Connection _____	\$ _____
Lead } _____	
Curb } Cock _____	in. \$ _____
} Valve _____	
} T. S. & V. _____	
Service box } Short 3½ x 4½ } _____	\$ _____
Old returned } Long 4½ x 5½ } _____	
10½ Ft. ¾ in. } Copper } Pipe at _____	\$ _____
} G. I. } _____	
} C. I. } _____	
Nipples _____ in. at _____	\$ _____
Bushings _____ to _____ in. at _____	\$ _____
Red'g } Coupl'gs _____ to _____ in. at _____	\$ _____
Inc'g } _____	
Union _____ in. at _____	\$ _____
Meter _____ in. at _____	\$ _____
_____	\$ _____
Compound Joints at _____	\$ _____
Maintenance Foreman _____	\$ _____
Hrs. Water Maint. Man—1 at _____	\$ _____
Hrs. Water Maint. Man—2 at _____	\$ _____
Hrs. Garage Foreman _____ at _____	\$ _____
Hrs. Labor— _____ at _____	\$ _____
Hrs. Compressor at _____	\$ _____
_____	\$ _____
Trucking _____	\$ _____
Pav't Patch _____	\$ _____
_____	\$ _____
_____	\$ _____
_____	\$ _____
_____	\$ _____

St.  
Pl.  
Ave. No. 594

Leonard

Name of Owner  
Anthony Jones

Labor and Mat'l. Report 19 88

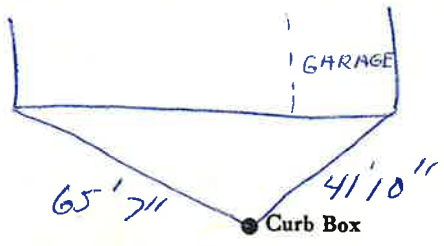

Main Elev. of Main at tap \_\_\_\_\_

Gate at ● ● Gate at \_\_\_\_\_

● Curb Box