


LABOR AND MATERIALS

Copper } Connection _____	\$ _____
Lead } _____	\$ _____
Curb } Cock _____	\$ _____
} Valve _____	\$ _____
} T. S. & V. _____	in. _____ \$ _____
Service box } Short 3½ x 4½ _____	\$ _____
Old returned } Long 4½ x 5½ _____	\$ _____
Ft. <u>¾</u> in. } Copper _____	\$ _____
} G. I. _____	\$ _____
} G. I. _____	Pipe at _____ \$ _____
Nipples _____ in. at _____	\$ _____
Bushings _____ to _____ in. at _____	\$ _____
Red'g } Coupl'gs _____ to _____ in. at _____	\$ _____
Inc'g } _____	\$ _____
Union _____ in. at _____	\$ _____
Meter _____ in. at _____	\$ _____
_____	\$ _____
Compound Joints at _____	\$ _____
Maintenance Foreman _____	\$ _____
Hrs. Water Maint. Man—1 at _____	\$ _____
Hrs. Water Maint. Man—2 at _____	\$ _____
Hrs. Garage Foreman _____ at _____	\$ _____
Hrs. Labor— _____ at _____	\$ _____
Hrs. Compressor at _____	\$ _____
_____	\$ _____
Trucking _____	\$ _____
Pav't Patch _____	\$ _____
_____	\$ _____
_____	\$ _____
_____	\$ _____
_____	\$ _____

St. Leonard
~~Pl.~~ No. 60
 Ave. No. _____

Name of Owner _____

Labor and Mat'l. Report Oct 19 89

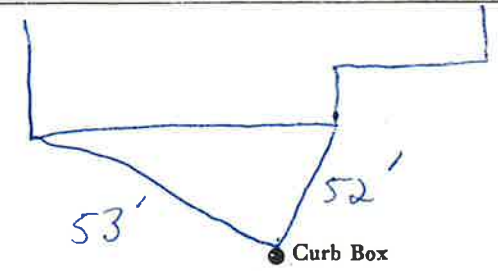

Main Elev. of Main at tap _____

Gate at • _____ • Gate at _____

• Curb Box