

# LABOR AND MATERIALS

1. Copper } Connection $\frac{3}{4}$ in. ....	2.94
Lead } .....	
1. Curb } Cock Valve } $\frac{3}{4}$ in. ....	3.71
T. S. & V. } .....	
1. Service box } Short $3\frac{1}{2} \times 4\frac{1}{2}$ } .....	5.90
Old returned } Long $4\frac{1}{2} \times 5\frac{1}{2}$ } .....	
Buff or Rdway } .....	
45 Ft. $\frac{3}{4}$ in. } Copper } Pipe at 30	13.50
} G. I. } .....	
} C. I. } .....	
Nipples..... in. at .....	\$
Bushings..... to..... in. at .....	\$
Red'g } .....	
Inc'g } Coupl'gs..... to..... in. at .....	\$
Union..... in. at .....	\$
Meter..... in. at .....	\$
Lead Joints at .....	\$
Compound Joints at .....	\$
5 Hrs. Water Maint. Man-1 at 1.01	5.05
1 Hrs. Water Maint. Man-2 at 9.1	9.10
20 Hrs. Labor..... at 8.0	16.00
Hrs. Labor..... at .....	\$
3 Hrs. Compressor at .....	\$
Compensation Ins. at \$..... per C	61
Trucking.....	1.00
Pav't Patch.....	\$
Tap by Warkinski.....	\$
O'head.....	\$
	\$ 55.08

41


St. Leonard  
 Ph. Ave. No. 14

Name of Owner

D & H Railroad Co

Labor and Mat'l. Report

May 18 1925

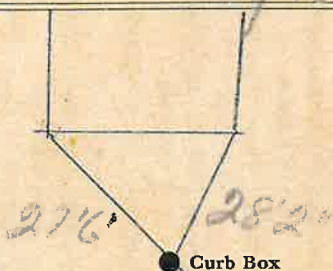

Main

Elev. of Main at tap 5.4

Gate at ●

● Gate at

● Curb Box