

Labor and Materials		\$
1	Lead Connection	\$
	Curb Cock	\$
1	Service Box (Short 3 1/2 x 4)	\$
	Old returned (Long 4 1/2 x 6)	\$
10	1 1/2 in. G. I. Pipe at	\$
	Nipples in at	\$
	Bushings to in at	\$
	Red'g Coup to in at	\$
	Inc'g Coup to in at	\$
	Union in at	\$
	Meter in at	\$
	Cu. Yds. Br. Stone at	\$
	Cu. Yds. Sand at	\$
	Bags Cement at	\$
	Paving Brick (Mack Red Asphalt) at	\$
2	Hrs. Foreman at	\$
	Hrs. Common Labor at	\$
	Hrs. Mason at	\$
	Hrs. at	\$
	Hrs. at	\$
7.0	Builders' Use of Water	\$
	Trucks 10.0	\$
	at	\$
	at	\$
	at	\$
	Total	\$ 921

19 July 1924
Labor and Material Report 10

7 Leonard St

4 Main Elev. of Main at tap 41

Gate at ● Gate at ●

● Curb Box


LABOR AND MATERIALS

Copper } Connection	\$
Lead }	\$
Curb { Clock Valve }	\$
T. S. & V. }	\$
Service box } Short 3 1/2 X 4 1/2 }	\$
Old returned } Long 4 1/2 X 5 1/2 }	\$
Buff or Rdway }	\$
Ft. in. } Copper } Pipe at	\$
Galv. Iron }	\$
Cast Iron }	\$
Nipples in. at	\$
Bushings to in. at	\$
Red'g } Couplings	\$
Inc'g } to in. at	\$
Union in. at	\$
Meter in. at	\$
Lead Joints at	\$
Compound Joints at	\$
Hrs. Foreman at	\$
Hrs. Chauffeur at	\$
Hrs. Tapper at	\$
Hrs. Labor at	\$
Hrs. Labor at	\$
Hrs. Compressor at	\$
Compensation Ins.	\$
Trucking	\$
Builders Use of Water	\$
<i>Walsinski & Geo</i>	\$
.....	\$
.....	\$
St. 19
Pl. 7
Ave. No. 7

Name of Owner Leonard

Labor and Mat'l. Report June 19 45

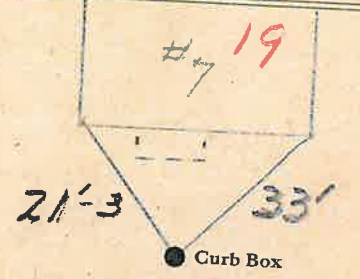

Main Elev. of
Main at tap
Gate at ● ● Gate at

● Curb Box