

LABOR AND MATERIALS


1	Copper Lead	{ Connection	$\frac{3}{4}$ "	\$ 3.04
1	Curb	{ Cook Valve T.S. & V.	$\frac{3}{4}$ in.	\$ 3.54
1	Service box Old returned	{ Short $3\frac{1}{2} \times 4\frac{1}{2}$ Long $4\frac{1}{2} \times 5\frac{1}{2}$ Buff. or Rdway.		\$ 4.70
19	Ft. $\frac{3}{4}$ in.	{ Copper C.I. C.I.	Pipe at 35	\$ 6.65
	Nipples	in. at		\$
	Bushings	to in. at		\$
	Red'g Inc'g	{ Coupl'gs to in. at		\$
	Union	in. at		\$
	Meter	in. at		\$
	Lead Joints at			\$
	Compound Joints at			\$
	Hrs. Water Maint. Man—1 at			\$
8	Hrs. Water Maint. Man—2 at	1.13		\$ 9.04 ²⁰
8	Hrs. Labor— at	1.02		\$ 8.16 ²⁰
	Hrs. Labor— at			\$
2	Hrs. Compressor at	1.50		\$ 3.00
	Compensation Ins. at \$ 2.66 per C.			\$.44
	Trucking			\$ 1.00
	Pav't Patch			\$ 11.20
				\$
				\$
	O'head			\$
	Tap by Gifford			\$ 50.79
	7-24-51			

107-1951

Leonard St. Ave. No. 21

Name of Owner
Diviney

Labor and Mat'l. Report July 24 19 51

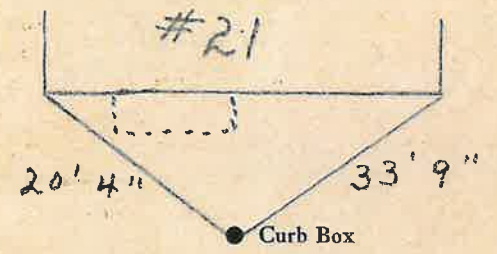

4" Main Elev. of Main at tap 5'

Gate at ● Gate at ●

● Curb Box