


Labor and Materials

1	Copper } Connection.....	$\frac{3}{4}$	\$ 3.20
	Lead }		
1	Curb } Cock }	$\frac{3}{4}$ in.	\$ 1.50
	Valve }		
	T. S. & V. }		
1	Service Box } Short 3" x 4" }		\$ 1.40
	Old returned } Long 4" x 5" }		
		Bull. or Redway }	
98	Ft. }	$\frac{3}{4}$ in. } Copper } Pipe at.....	\$ 8.36
	Nipples.....	in. at.....	\$
1	Bushings.....	$\frac{1}{2}$ to $\frac{3}{4}$ in. at.....	\$ 1.15
	Red'g } Couplings.....	to..... in. at.....	\$
	Inc'g }		
	Union.....	in. at.....	\$
	Meter.....	in. at.....	\$
	Lbs Br. Stone at.....		\$
	Lbs. Sand at.....		\$
	Bags Cement at.....		\$
	Paving Brick } Mack } at.....		\$
		Red }	
		Asphalt }	
	Lead Joints at.....		\$
	Leadite Joints at.....		\$
3	Hrs. Foreman at.....	12.5	\$ 1.87
28	Hrs. Common Labor at.....	40.6	\$ 1.38
	Hrs. Common Labor at.....		\$
	Hrs. Mason at.....		\$
	Hrs. Mason's Helper at.....		\$
	Hrs. Compressor at.....		\$
	Compensation Ins.....		\$.35
1	Trucking.....		\$ 1.00
	Builders' Use of Water.....		\$
Total			\$ 28.71

27-102 24
 Labor and Material Report June 24 1925

10 Leonard St

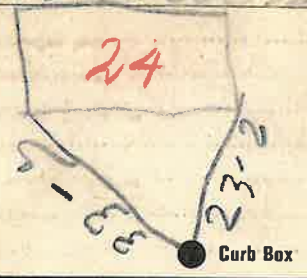

VI Main Elev. of Main at tap 5
 Gate at ● Gate at ●

● Curb Box

old tap disconnected