

LABOR AND MATERIALS

1	Copper	Connection	3/4"	\$	_____
1	Lead	Cock	3/4" in.	\$	_____
1	Curb	Valve	3/4" in.	\$	_____
		T. S. & V.			
1	Service box	Short 3 1/2 x 4 1/2		\$	_____
	Old returned	Long 4 1/2 x 5 1/2		\$	_____
		Buff-or-Rdway		\$	_____
10	Ft.	Copper	3/4" in.	Pipe at	\$ _____
		G. I.			
		C. I.			
	Nipples	in. at		\$	_____
	Bushings	to in. at		\$	_____
	Red'g	Coupl'gs	to in. at	\$	_____
	Inc'g				
	Union	in. at		\$	_____
	Meter	in. at		\$	_____
	Lead Joints at			\$	_____
	Compound Joints at			\$	_____
	Maintenance Foreman			\$	_____
	Hrs. Water Maint. Man	1 at		\$	_____
	Hrs. Water Maint. Man	2 at		\$	_____
	Hrs. Garage Foreman	at		\$	_____
	Hrs. Labor	at		\$	_____
	Hrs. Compressor at			\$	_____
	Compensation Ins. at \$	per C		\$	_____
	Trucking			\$	_____
	Pav't Patch			\$	_____
	Tap by G. Lissard &			\$	_____
	Co. 8-19-59.			\$	_____
	O'head			\$	_____


St. _____
 Pl. _____
 Ave. No. 16

Name of Owner

Leonard

Labor and Mat'l. Report

Aug 19 19 59

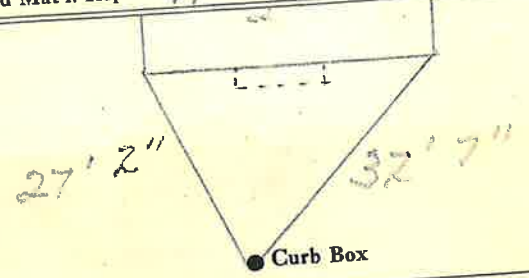

6" Main

Elev. of Main at tap 6 1/2'

Gate at •

• Gate at

• Curb Box