


**Labor and Materials**

1	Lead Connection	.....	\$.
1	Curb Cock	.....	\$.
1	Service Box (Short 3 1/2 x 4 1/2) Old returned (Long 4 1/2 x 5 1/2) Buffalo	.....	\$.
26	Ft. in. G. I. Pipe at	.....	\$.
	Nipples..... in. at	.....	\$.
	Bushings..... to..... in. at	.....	\$.
	Red'g Coup..... to..... in. at	.....	\$.
	Inc'g Coup..... to..... in. at	.....	\$.
	Union..... in. at	.....	\$.
	Meter..... in. at	.....	\$.
	Cu. Yds. Br. Stone at	.....	\$.
	Cu. Yds. Sand at	.....	\$.
	Bags Cement at	.....	\$.
	Paving Brick { Mack Red Asphalt } at	.....	\$.
2 1/2	Hrs. Foreman at	.....	\$.
1.5	Hrs. Common Labor at	.....	\$.
	Hrs. Mason at	.....	\$.
	Hrs. at	.....	\$.
	Hrs. at	.....	\$.
	Builders' Use of Water	.....	\$.
	at	.....	\$.
	at	.....	\$.
	at	.....	\$.
	Total	\$.....	

19 Labor and Material Report Sep 19 19 15

13 ROBERTS AVE

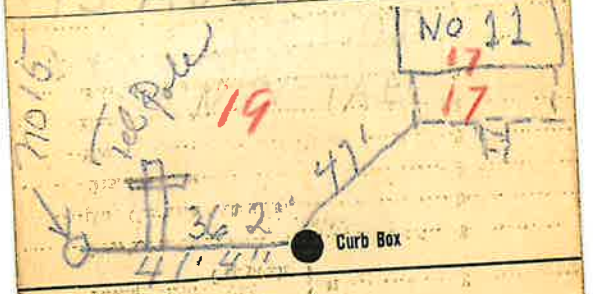

Elev. of Main at tap  
Main  
Gate at

Curb Box  
26