


Labor and Materials

1. Dead Connection ^{3/4} \$
1. Curb Cock ^{3/4} \$
1. Service Box ^{Sheet 31 x 41} Long 4 1/2 x 5 1/2 \$
Old returned Buffalo
11. Ft. ^{3/4} in. D.I. Pipe at ^{cap} \$
Nipples in. at \$
1. Bushings ^{3/4} to ^{1/2} in. at \$
Red'g Coup. to in. at \$
Inc'g Coup. to in. at \$
Union in. at \$
Meter in. at \$
Cu. Yds. Br. Stone at \$
Cu. Yds. Sand at \$
Bags Cement at \$
Paving Brick ^{Mack} ^{Red} ^{Asphalt} } at \$
2 Hrs. Foreman at \$
13 Hrs. Common Labor at \$
Hrs. Mason at \$
Hrs. at \$
Hrs. at \$
Builders' Use of Water \$
..... at \$
..... at \$
..... at \$
..... at \$
Total \$.....

6
Labor and Material Report


Sept 10 1923

2 ROBERTS AVE

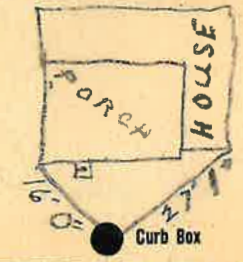

6" Main Elev. of Main at tap 6

Gate at ● TAX ID # 302.12-10-19 ● Gate at

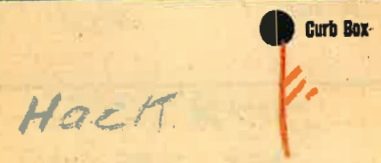

M.