

LABOR AND MATERIALS

1	Copper	} Connection <u>3/4"</u>	\$
1	Curb		} Cock <u>3/4</u> in.
1	Service box	} { Short <u>3 1/2</u> x <u>4 1/2</u> Long <u>4 1/2</u> x <u>3 1/2</u> Cast Iron	
26	Ft. <u>3/4</u> in.		} { Copper C.I. C.I.
	Nipples	in. at \$	
	Bushings	to in. at \$	
	Red'g	} Coupl'gs. to in. at \$	
	Inc'g		
	Union	in. at \$	
	Meter	in. at \$	
	Lead Joints	at \$	
	Compound Joints	at \$	
	Maintenance Foreman	\$	
	Hrs. Water Maint. Man-1	at \$	
	Hrs. Water Maint. Man-2	at \$	
	Hrs. Garage Foreman	at \$	
	Hrs. Labor	at \$	
	Hrs. Compressor	at \$	
	Compensation Ins. at \$	per C \$	
	Trucking	\$	
	Pav't Patch	\$	
		\$	
		\$	
	O'head	\$	


Used old Lot TAP FOR #27
Lexington Ave.

TAP MADE Sept-11-1925

Lexington St. Ave. No. 25

Name of Owner
FRANK Herlihy

Labor and Mat'l. Report JUNE 26 1923

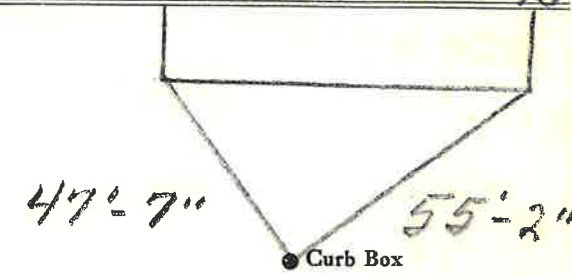

6" Main Elev. of Main at tap 6'
Gate at • Gate at •

• Curb Box