

LABOR AND MATERIALS


1	Copper Lead	Connection	3/4"	\$
1	Curb	Cock Valve T. S. & V.	3/4 in.	\$
1	Service box -Old returned	Short 3 1/2 x 4 1/2 Long 4 1/2 x 5 1/2 Buff or Rdway		\$
26	Ft.	3/4 in. Copper G. I. C. I.	Pipe at	\$
	Nipples	in. at		\$
	Bushings	to in. at		\$
1	Red'g Inc'g	Coupl'gs.	Brass to in. at	\$
	Union	in. at		\$
	Meter	in. at		\$
	Lead Joints at			\$
	Compound Joints at			\$
	Maintenance Foreman			\$
	Hrs. Water Maint. Man—1 at			\$
	Hrs. Water Maint. Man—2 at			\$
	Hrs. Garage Foreman	at		\$
	Hrs. Labor—	at		\$
	Hrs. Compressor at			\$
	Compensation Ins. at \$	per C.		\$
	Trucking			\$
	Pav't Patch			\$
				\$
				\$
	O'head			\$
				\$

30-54

St. Pl. Ave. No. 33

Lexington

Name of Owner
(Trailer House)
Remeasured 6-24-54
Labor and Mat'l. Report Sept 15 1925

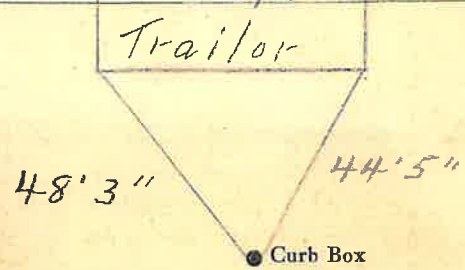

6" Main Elev. of Main at tap 5'6"

Gate at • • Gate at

• Curb Box