


Labor and Materials

Copper	} Connection	\$	
Lead		\$	
Curb	} Cock Valve T. S. & V. } in	\$	
Service Box		} Short 3½ x 4½ Long 4½ x 5½ Buff. or Rdway }	\$
Old returned			\$
Ft. in.	} Copper Galv Iron Cast Iron }	Pipe at	\$	
Nipples	 in. at	\$	
Bushings	 to in. at	\$	
Red'g Inc'g	} Conplings to in. at	\$	
Union	 in. at	\$	
Meter in. at	\$		
Lead Joints	at	\$		
Leadite Joints	at	\$		
Hrs. Foreman	at	\$		
Hrs. Chauffeur	at	\$		
Hrs. Tapper	at	\$		
Hrs. Labor	at	\$		
Hrs. Labor	at	\$		
Hrs. Compressor	at	\$		
Compensation Ins.		\$		
Trucking		\$		
Builders Use of Water		\$		
		\$		
		\$		
St. 31
Pl. 25
Ave. No. 25

Name of Owner
McKinney

Labor and Mat'l. Report 10-26-21 19

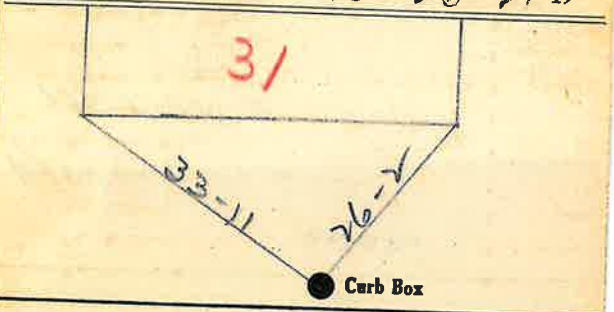

6 Main Elev. of Main at tap 6

Gate at • Gate at

• Curb Box