

LABOR AND MATERIALS

Copper	} Connection	_____	\$
Lead		_____	\$
Curb	} Cock Valve T. S. & V. }	_____ in.	\$
		_____	\$
		_____	\$
Service box	} Short 3½ x 4½ Long 4½ x 5½ }	_____	\$
Old returned		_____	\$
26 Ft. 3/4 in.	} Copper G. I. C. I. }	Pipe at _____	\$
		_____	\$
Nipples	in. at _____	\$	
Bushings	to _____ in. at _____	\$	
Red'g Inc'g	} Coupl'gs	to _____ in. at _____	\$
Union		in. at _____	\$
Meter	in. at _____	\$	
		_____	\$
Compound Joints	at _____	\$	
Maintenance Foreman	_____	\$	
Hrs. Water Maint. Man—1	at _____	\$	
Hrs. Water Maint. Man—2	at _____	\$	
Hrs. Garage Foreman	at _____	\$	
Hrs. Labor—	at _____	\$	
Hrs. Compressor	at _____	\$	
		_____	\$
Trucking	_____	\$	
Pav't Patch	_____	\$	
		_____	\$
		_____	\$

LEXINGTON

St. _____
Pl. _____
Ave. No. 33

Name of Owner _____

Labor and Mat'l. Report

19

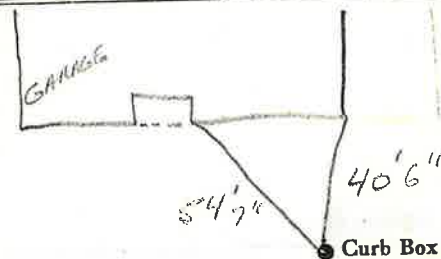

Main _____ Elev. of Main at tap _____
Gate at • _____ Gate at • _____

• Curb Box

REMEASURED 2000

NEW HOUSE ON LOT

Labor and Materials

Lead Connection	\$
Curb Cock	\$
Service Box	(Short 3/4 x 4)	\$
Old returned	(Long 4 1/2 x 5 1/2)	\$
26 Ft.	in. G. I. Pipe at	\$
Nipples	in. at	\$
Bushings	to in. at	\$
1 Red'g Coup	to in. at <i>Brass</i>	\$
Inc'g Coup	to in. at	\$
Union	in. at	\$
Meter	in. at	\$
Cu. Yds. Br. Stone	at	\$
Cu. Yds. Sand	at	\$
Bags Cement	at	\$
Paving Brick	{ Mack Red Asphalt } at	\$
2 1/2 Hrs. Foreman	at	\$
1 1/2 Hrs. Common Labor	at	\$
Hrs. Mason	at	\$
Hrs.	at	\$
Hrs.	at	\$
Builders' Use of Water	at	\$
	at	\$
	at	\$
	at	\$
	at	\$
Total		\$

Labor and Material Report

19

Lexington

277 ~~400~~ AVE

70

33

33

66'

33

72' 3"

● Curb Box

Main

Elev. of
Main at tap *6*

Gate at ●

● Gate at

● Curb Box