

LABOR AND MATERIALS

1	Copper Lead	Connection	3/4"		\$
1	Curb	Cock Valve	3/4 in.		\$
1	Service box	Short 3 1/2 x 4 1/2			\$
	Old returned	Long 4 1/2 x 5 1/2			\$
		Buff or Rdway			\$
26	Ft. 3/4 in.	Copper		Pipe at	\$
		G.I.			\$
		G.I.			\$
	Nipples	in. at			\$
	Bushings	to in. at			\$
	Red'g				\$
	Inc'g	Coupl'gs	to in. at		\$
	Union	in. at			\$
	Meter	in. at			\$
	Lead Joints	at			\$
	Compound Joints	at			\$
2 1/2	Maintenance Foreman				\$
	Hrs. Water Maint. Man-1	at			\$
	Hrs. Water Maint. Man-2	at			\$
	Hrs. Garage Foreman	at			\$
15	Hrs. Labor	at			\$
	Hrs. Compressor	at			\$
	Compensation Ins.	at \$			\$
	Trucking	per C.			\$
	Pav't Patch				\$
					\$
					\$
					\$
					\$
	O'head				\$

EMPTY LOT


Lexington

-St.
-Pl.
Ave. No. 35

Name of Owner _____

Remeasured 6-24-54

Labor and Mat'l. Report Sept. 15 1925

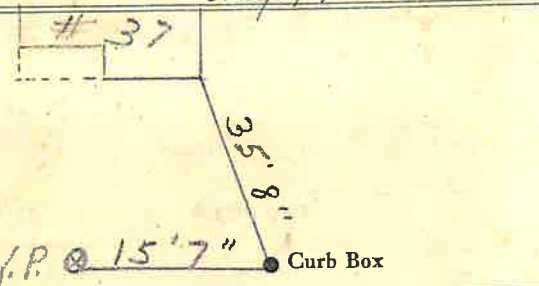

File #8

6" Main

Elev. of Main at tap 5'

Gate at ● ● Gate at

● Curb Box

Tap for Lot #35

Measured from #37