


### LABOR AND MATERIALS

1	Copper	}	Connection	<u>3/4"</u>	\$
1	Lead	}	Cock		
1	Curb	}	Valve	<u>3/4 in.</u>	\$
			T.S. & V.	<u>Oriseal.</u>	
1	Service box	}	Short $3\frac{1}{2} \times 4\frac{1}{2}$		
	Old returned		Long $4\frac{1}{2} \times 5\frac{1}{2}$		
			Buff. or Rdway		\$
10	Ft.	}	Copper	Pipe at	\$
	<u>3/4 in.</u>		G.I.		
			C.I.		
	Nipples	in. at			\$
	Bushings	to in. at			\$
	Red'g	} Coupl'gs	to in. at		\$
	Inc'g				
	Union	in. at			\$
	Meter	in. at			\$
	Lead Joints at				\$
	Compound Joints at				\$
	Maintenance Foreman				\$
	Hrs. Water Maint. Man-1 at				\$
	Hrs. Water Maint. Man-2 at				\$
	Hrs. Garage Foreman at				\$
	Hrs. Labor at				\$
	Hrs. Compressor at				\$
	Compensation Ins. at \$		per C		\$
	Trucking				\$
	Pav't Patch				\$
	<u>Tap by Lareaut Co.</u>				\$
	<u>5-12-69.</u>				\$
	O'head				\$

St. \_\_\_\_\_  
Pl. \_\_\_\_\_  
Ave. No. 44

Name of Owner  
Adelbert Wells Est.

Labor and Mat'l. Report May 12 1969

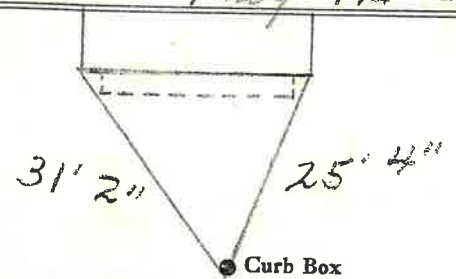

6" Main                      Elev. of Main at tap 5'  
Gate at ●                                      ● Gate at

● Curb Box  
Tap made due to  
leak at main.