


LABOR AND MATERIALS

Copper	} Connection		\$
Lead			
Curb	{ Clock Valve		\$
		T. S. & V.	in.
Service box	{ Short 3 1/2 X 4 1/2		
Old returned		Long 4 1/2 X 5 1/2	
		Buff or Rdway	\$
Ft.	{ Copper	} Pipe at	\$
in.			Galv. Iron
			Cast Iron
Nipples	in. at	\$	
Bushings	to in. at	\$	
Red'g Inc'g	} Couplings	to in. at	\$
Union		in. at	\$
Meter	in. at	\$	
Lead Joints	at	\$	
Compound Joints	at	\$	
Hrs. Foreman	at	\$	
Hrs. Chauffeur	at	\$	
Hrs. Tapper	at	\$	
Hrs. Labor	at	\$	
Hrs. Labor	at	\$	
Hrs. Compressor	at	\$	
Compensation Ins.		\$	
Trucking		\$	
Builders Use of Water		\$	
Warsinski & Co.		\$	
		\$	
		\$	
St. 60
Pl. 50
Ave. No.

Name of Owner

Labor and Mat'l. Report June 19 45

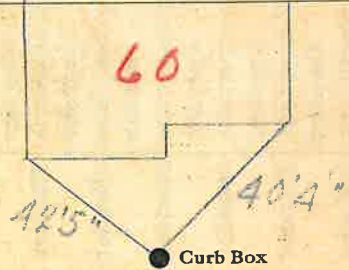

Main Elev. of Main at tap
Gate at ● Gate at ●

● Curb Box