


Labor and Materials

Copper } Connection.....	3	\$ 1.50
Lead } .....	4	
Curb { Cock Valve } .....	3'	\$ 1.70
{ P.S. & V. } .....		
Service Box { Short 3 1/2 x 4 1/2 } .....		\$ 1.50
Old returned { Long 4 1/2 x 5 1/2 } .....		
{ Buff. or Rawas } .....		
2 1/2 Ft. 3/4 in. { Copper } Pipe at .....		\$ 4.75
{ Galv. Iron } .....		
{ Cast Iron } .....		
Nipples .....	in. at	\$ .....
Bushings .....	to .....	in. at \$ .....
Red'g } Couplings.....	to .....	in. at \$ .....
Inc'g } .....		
Union.....	in. at	\$ .....
Meter.....	in. at	\$ .....
Lbs. Br. Stone at .....		\$ .....
Lbs. Sand at .....		\$ .....
Bags Cement at .....		\$ .....
Paving Brick { Mack } at .....		\$ .....
{ Red } .....		
{ Asphalt } .....		
Lead Joints at .....		\$ .....
Leadite Joints at .....		\$ .....
2 Hrs. Foreman at .....	67 1/2	\$ 1.25
2 Hrs. Common Labor at .....	50	\$ 1.00
8 Hrs. Common Labor at .....	45	\$ 3.60
Hrs. Mason at .....		\$ .....
Hrs. Masons Helper at .....		\$ .....
Hrs. Compressor at .....		\$ .....
Compensation Ins .....		\$ 0.25
Trucking .....		\$ 1.00
Builders Use of Water .....	Paul Patch	\$ 2.50
Total		\$ 22.16

139 34 63 Labor and Material Report Nov 22 1934

43 Lexington Ave

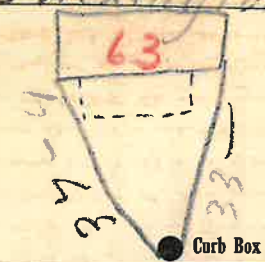

6 Main Elev. of Main at tap 43  
 Gate at ● Gate at ●

● Curb Box

New Tap.

*[Handwritten signature]*