


### Labor and Materials

Copper	Lead	Connection	.....	\$ 2.60
Curb	Cock Valve	T.S. & V.	..... in.	\$ 2.27
Service Box	Old returned	Short 3 1/2 x 1 1/2 Long 4 1/2 x 5 1/2 Buff. or Rdway	.....	\$ 1.59
20 Ft.	..... in.	Copper Galv. Iron Cast Iron	Pipe at.....	\$ 3.60
Nipples	..... in.	at.....		\$
Bushings	..... to.....	in. at.....		\$
Red'g Inc'g	Couplings	..... to.....	in. at.....	\$
Union	..... in.	at.....		\$
Meter	..... in.	at.....		\$
Lbs. Br. Stone	at.....			\$
Lbs. Sand	at.....			\$
Bags Cement	at.....			\$
Paving Brick	Mack Red Asphalt	at.....		\$
Lead Joints	at.....			\$
Leadite Joints	at.....			\$
2 Hrs.	Foreman	at.....		\$ 1.25
7 Hrs.	Common Labor	at.....		\$ 3.15
Hrs.	Common Labor	at.....		\$
Hrs	Mason	at.....		\$
Hrs	Mason's Helper	at.....		\$
Hrs.	Compressor	at.....		\$
Compensation	Ins	.....		\$ .14
Trucking	.....			\$ 1.-
Builders' Use of Water	Patrol (Sumer)	.....		\$
Total \$				75.60

### Labor and Material Report

65' Oct 29 1931

45 ~~Robert's~~ RIVE

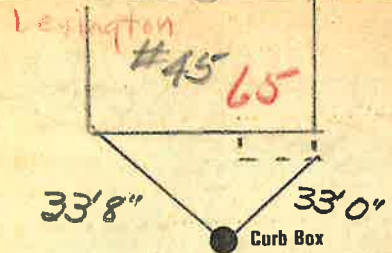

6 Main Elev of Main at tap 4 1/2  
Gate at ● Gate at ●

● Curb Box

New House