


Labor and Materials

Copper } Connection.....	\$
Lead }	\$
2 Curb { Cock Valve }	\$ 2.00
{ T.S. & V. }	
1 Service Box { Short 3' x 4' }	\$ 1.40
Old returned { Long 4' x 5' }	
{ Butt. or Rdway }	
25 Ft. 3/4 in. { Copper } Pipe at.....	\$ 5.50
{ Galv. Iron }	
{ Cast Iron }	
1 Nipples 3/4 in. at.....	\$.25
Bushings..... to..... in. at.....	\$
Red'g } Couplings..... to..... in. at.....	\$
Inc'g }	
Union..... in. at.....	\$
Meter..... in. at.....	\$
Lbs. Br. Stone at.....	\$
Lbs. Sand at.....	\$
Bags Cement at.....	\$
Paving Brick { Mack } at.....	\$
{ Red }	
{ Asphalt }	
Lead Joints at.....	\$
Leadite Joints at.....	\$
9 Hrs. Foreman at.....	\$ 1.80
13 Hrs. Common Labor at.....	\$ 5.20
Hrs. Common Labor at.....	\$
Hrs. Mason at.....	\$
Hrs. Mason's Helper at.....	\$
Hrs. Compressor at.....	\$
Compensation Ins.....	\$ 1.90
Trucking.....	\$ 1.00
Builders' Use of Water.....	\$
Total \$ 17.33	

Washington Ave

Labor and Material Report *Aug* 1 192*4*

Roberts Ave manhole no

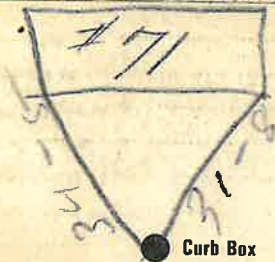

Number

2 gal Main

Elev. of Main at tap *2 ft*

Gate at ●

● Gate at

● Curb Box

31'8"

34'2"