


Labor and Materials

1 Lead Connection	\$
1 Curb Cock	\$
1 Service Box (Short 8 x 7)	\$
Old returned (Long 4 1/2 x 6 1/2)	
Buffalo	
15 Ft. 3/4 in. G.I. Pipe at	\$
Nipples in. at	\$
1 Bushings 1/4 to 1/2 in. at	\$
Red'g Coup. to in. at	\$
Inc'g Coup. to in. at	\$
Union in. at	\$
Meter in. at	\$
Cu. Yds. Br. Stone at	\$
Cu. Yds. Sand at	\$
Bags Cement at	\$
Paving Brick { Mack Red Asphalt } at	\$
2 Hrs. Foreman at	\$
13 Hrs. Common Labor at	\$
Hrs. Mason at	\$
Hrs. at	\$
Hrs. at	\$
Builders' Use of Water	\$
at	\$
at	\$
at	\$
at	\$
Total	\$

Labor and Material Report

Sept 16 1921

6 ROBERTS AVE

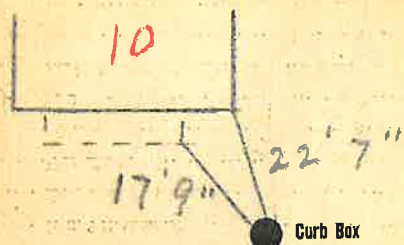

Main

Elev. of Main at tap

Gate at ●

● Gate at

● Curb Box

Prepared by [illegible]