

Labor and Materials


Copper Lead	Connection	\$ 7.70
Curb	Cock Valve in.	\$ 2.31
Service Box	Short 3/4x1/2	\$ 1.45
Old returned	Buff. on Rdway	
26 Ft.	in.	Copper Galv. Iron Cast Iron	Pipe at	\$ 7.02
Nipples in. at	\$
Bushings to in. at	\$
Red'g Inc'g	Couplings to in. at	\$
Union in. at	\$
Meter in. at	\$
Lbs. Br. Stone	at	\$
Lbs. Sand	at	\$
Bags Cement	at	\$
Paving Brick	Mack Red Asphalt at	\$
Lead Joints	at	\$
Leadite Joints	at	\$
3 Hrs.	Foreman at	\$ 1.88
12 Hrs.	Common Labor at	\$ 5.40
..... Hrs.	Common Labor at	\$
..... Hrs.	Mason at	\$
..... Hrs.	Mason's Helper at	\$
..... Hrs.	Compressor at	\$
.....	Compensation Ins	\$.23
.....	Trucking	\$ 1.-
.....	Builders' Use of Water	\$ 5.-
Total \$				27.07

30-142

Labor and Material Report

Oct 14 1920

3 Liberty Ave

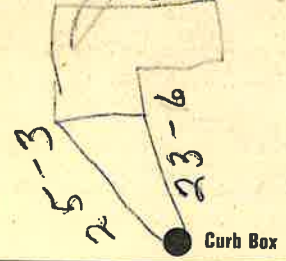

6 Main

Elev of Main at tap

Gate at ●

● Gate at

● Curb Box

New house
Judge Beckwith

✓