

Labor and Materials


Copper	Lead	Connection	3	\$ 2.60	
Curb	Cock Valve	T.S. & V.	in.	31	\$ 2.30
Old returned	Long 4x5 1/2	Bull or Runway			
5	3/4	Copper Galv. Iron	Pipe at	14	\$ 1.33
Nipples	in. at				\$
Bushings	to	in. at			\$
Red'g Inc'g	Couplings	to	in. at		\$
Union	in. at				\$
Meter	in. at				\$
Lbs. Br. Stone	at				\$
Lbs. Sand	at				\$
Bags Cement	at				\$
Paving Brick	Mack Red Asphalt	at			\$
					\$
					\$
Lead Joints	at				\$
Leadite Joints	at				\$
2	Hrs. Foreman	at			\$ 1.25
Hrs. Common Labor	at				\$
Hrs. Common Labor	at				\$
Hrs. Mason	at				\$
Hrs. Mason's Helper	at				\$
Hrs. Compressor	at				\$
Compensation Ins					\$.03
Trucking					\$ 1.00
Builders' Use of Water	Patch				\$ 5.00
Total				149.1	\$

29-58

Labor and Material Report

July 20 1926

14 Lincoln Ave.

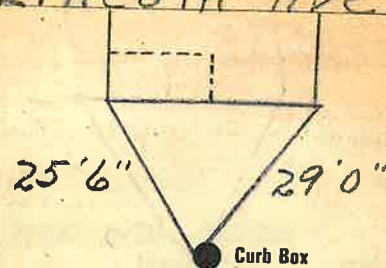

16 Main Elev of Main at tap 4
 Gate at ● Gate at ●

● Curb Box

New House