


Labor and Materials

1	Copper	} Connection <i>3/4"</i>	\$ 1.25
	Lead			
1	Curb	} <i>3/4"</i> in	\$ 1.70
	Cock Valve T.S.&V.			
1	Service Box	} <i>Short 3 1/2 x 4 1/2</i> <i>Long 4 1/2 x 5 1/2</i> <i>Buff or Raw</i>	\$ 1.45
	Old returned			
42	Ft. <i>3/4"</i> in	} Copper Galv. Iron Cast Iron	Pipe at <i>13 1/2</i>	\$ 7.02
	Nipples			
	Bushings to	in. at	\$
	Red'g Inc'g	} Couplings to	in. at
	Union in. at	\$
	Meter in. at	\$
	Lbs. Br. Stone	at	\$
	Lbs. Sand	at	\$
	Bags Cement	at	\$
	Paving Brick	} Mack Red Asphalt	at	\$
	Lead Joints			
	Leadite Joints	at	\$
8	Hrs. Foreman	at <i>6 1/2</i>	\$ 5-
11	Hrs. Common Labor	at <i>50</i>	\$ 50-
16	Hrs. Common Labor	at <i>16</i>	\$ 72-
	Hrs. Mason	at	\$
	Hrs. Masons Helper	at	\$
	Hrs. Compressor	at	\$
	Compensation Ins	\$ 67
	Trucking	\$ 1-
	Builders Use of Water	<i>Patch</i>	\$ 5-
Total \$				<i>35.79</i>

1935 - 5

Labor and Material Report *Dec 12* 19*34*

3/4" tap at 17 Leimick Ave

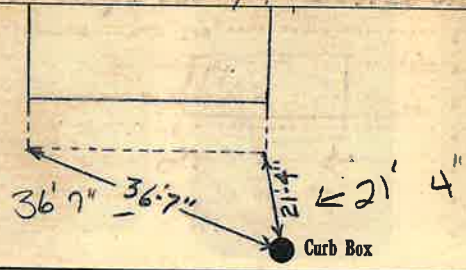

16 Main Elev. of Main at tap *44*

Gate at ● ● Gate at

● Curb Box

Old tap shut off

EPH