

1 1 7 - 1938

Lincoln

St.
Pl.
Ave. No. 20


Name of Owner

Williams

Labor and Mat'l. Report

Sept 2 1938

House

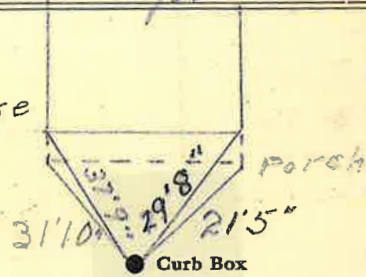

14 Main

Elev. of Main at tap 4 1/2

Gate at ●

● Gate at

● Curb Box

old shut off


LINCOLN

St.
Pl.
Ave. No. 20

Name of Owner

Outside Clean out

Labor and Mat'l. Report 19

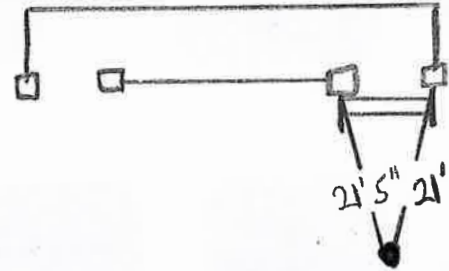

Main

Elev. of Main at tap

Gate at ●

● Gate at

TAX ID # 302.15-13-7

● Curb Box

