


Labor and Materials

| | | | | |
|-------|------------------------|---------------------|-----------------|----------|
| 1 | Copper | Connection | 3/4 | \$ 3.20 |
| 1 | Lead | | | |
| 1 | Curb | Cock Valve | 3/4 in. | \$ 1.00 |
| 1 | Service Box | Short 3 1/2 x 4 1/2 | | \$ 1.30 |
| | Old returned | Long 4 1/2 x 5 1/2 | | |
| | | Butt. or Rdway | | |
| 39 | Ft. | Copper Galv. Iron | 3/4 in. Pipe at | \$ 8.58 |
| 1 | Nipples | 3/4 in. | at | \$.12 |
| 1 | Bushings | 3/4 to 1 in. | at | \$.08 |
| 1 | Brass | Couplings | 1/2 in. at | \$.15 |
| | Union | | in. at | \$. |
| | Meter | | in. at | \$. |
| | Lbs. Br. Stone | at | | \$. |
| | Lbs. Sand | at | | \$. |
| | Bags Cement | at | | \$. |
| | Paving Brick | Mack Red Asphalt | at | \$. |
| | Lead Joints | at | | \$. |
| | Leadite Joints | at | | \$. |
| 4 | Hrs. Foreman | at | 6.25 | \$ 2.50 |
| 10 | Hrs. Common Labor | at | 5.00 | \$ 5.00 |
| 9 | Hrs. Common Labor | at | 4.08 | \$ 3.65 |
| | Hrs. Mason | at | | \$. |
| | Hrs. Mason's Helper | at | | \$. |
| | Hrs. Compressor | at | | \$. |
| | Compensation Ins. | | | \$.20 |
| | Trucking | | | \$ 1.00 |
| | Builders' Use of Water | | | \$. |
| Total | | | | \$ 26.88 |

Labor and Material Report

July 28 1926

21 Lincoln Ave

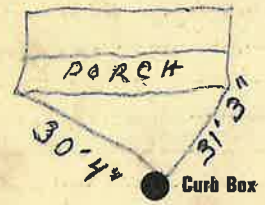

16" Main

Elev. of Main at tap 5'

Gate at ●

● Gate at

● Curb Box