

LABOR AND MATERIALS

1	Copper Lead	Connection	3/4	\$ 1.23
1	Curb	Cock Valve T. S. & V.	3/4 in.	\$ 1.68
1	Service Box Old returned	Short 3 1/2 x 4 1/2 Long 4 1/2 x 5 1/2 Buff. or Rdway		\$ 1.75
42	Ft.	3/4 in.	Copper Galv. Iron Cast Iron	Pipe at 15 \$ 6.30
	Nipples	in. at		\$
	Bushings	to in. at		\$
	Red'g Inc'g	Couplings	to in. at	\$
	Union	in. at		\$
	Meter	in. at		\$
	Lead Joints	at		\$
	Leadite Joints	at		\$
	Hrs. Foreman	at		\$
2	Hrs. Chauffeur	at	6 2 1/2	\$ 1.25
3	Hrs. Tapper	at	7	\$ 1.88
18	Hrs. Labor	at	45	\$ 8.10
	Hrs. Labor	at		\$
	Hrs. Compressor	at		\$
	Compensation Ins.			\$.35
	Trucking			\$ 1.00
	Builders Use of Water	repair (B.P.)		\$
	Tap by Bossell			\$
				\$
				\$
				\$
				\$
				\$ 23.54

1 1 8 - 1938


St.
Pl.
Ave. No. 23

Name of Owner

Wes M. Phillips

Labor and Mat'l. Report

Aug 27 1938

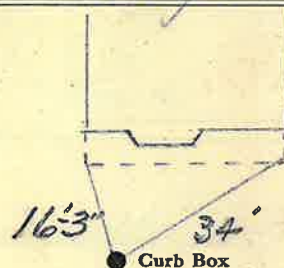

14 Main

Elev. of
Main at tap 4 1/2

Gate at ●

● Gate at

42' to main

● Curb Box

old shut off