

### LABOR AND MATERIALS

1	Copper Lead	Connection	3/4	-----	\$ 1.23
1	Curb	Cock Valve T. S. & V.	3/4 in.	-----	\$ 1.68
1	Service Box	Old returned	Short 3 1/2 x 4 1/2	} -----	\$ 1.75
			Long 4 1/2 x 5 1/2		
9	Ft.	3/4 in.	} Pipe at 15	} -----	\$ 1.35
-----	Nipples	in. at	-----	-----	\$
-----	Bushings	to	in. at	-----	\$
-----	Red'g Inc'g	} Couplings	to	in. at	\$
-----	Union		in. at	-----	-----
-----	Meter	in. at	-----	-----	\$
-----	Lead Joints	at	-----	-----	\$
-----	Leadite Joints	at	-----	-----	\$
-----	Hrs. Foreman	at	-----	-----	\$
2	Hrs. Chauffeur	at	6 1/2	-----	\$ 1.25
3	Hrs. Tapper	at	7	-----	\$ 1.88
18	Hrs. Labor	at	45	-----	\$ 8.10
-----	Hrs. Labor	at	-----	-----	\$
1	Hrs. Compressor	at	8 1/2	-----	\$ .88
-----	Compensation Ins.	at	-----	-----	\$ .35
-----	Trucking	at	-----	-----	\$ 1.00
-----	Builders Use of Water	at	hatched (B.A.)	-----	\$ -----
-----	Tap by Howell	at	-----	-----	\$ -----
-----	-----	-----	-----	-----	\$ -----
-----	-----	-----	-----	-----	\$ -----
-----	-----	-----	-----	-----	\$ -----
-----	-----	-----	-----	-----	\$ -----
					\$ 19.47

119 - 1938


~~St.~~  
~~Pl.~~  
 Ave. No. 24

Lincoln

Name of Owner

E. W. Robinson

Labor and Mat'l. Report Sept 2 1935

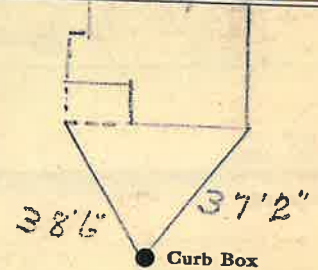

14 Main Elev. of Main at tap 41

Gate at ● ● Gate at

● Curb Box

old Tap Shut off