


Labor and Materials

1	Copper } Connection	3/4"	\$ 320
1	Curb { Cock Valve } T.S. & V. }	1/2" in.	\$ 100
1	Service Box } Old returned	Short 3" x 4" Long 4" x 5" Buff. or Rdway	\$ 140
6	Ft. } in. { Copper Galv. Iron } Pipe at		\$
	Nipples	in. at	\$
1	Bushings	3/4" to 1/2" in. at	\$.07
	Red'g } Inc'g { Couplings	to in. at	\$
	Union	in. at	\$
	Meter	in. at	\$
	Lbs. Br. Stone at		\$
	Lbs. Sand at		\$
	Bags Cement at		\$
	Paving Brick { Mack Red Asphalt }	at	\$
	Lead Joints at		\$
	Leadite Joints at		\$
	Hrs. Foreman at		\$
	Hrs. Common Labor at		\$
	Hrs. Common Labor at		\$
	Hrs. Mason at		\$
	Hrs. Mason's Helper at		\$
	Hrs. Compressor at		\$
	Compensation Ins.		\$
1	Trucking		\$ 100
	Builders' Use of Water		\$
	Total \$		

Labor and Material Report June 23 1911

no 30 service and

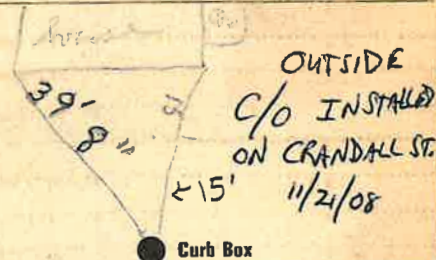

CRANDALL ST

10" Main

Elev. of Main at tap 5'

Gate at ●

● Gate at

TAX ID # 302.15-13-10

● Curb Box

old top sheet
off

Tap on Crandall
ST.

NOTE - REVERSE BOX -
"ON" POSITION IS OFF