


**Labor and Materials**

+	Copper } Connection.....	$\frac{3}{4}$	\$ 1.33
	Lead }		
1	Curb { Cock Valve in } .....in	$\frac{3}{4}$	\$ 1.58
1	Service Box { Short $3\frac{1}{2} \times 4\frac{1}{2}$ Old returned { Long $4\frac{1}{2} \times 5\frac{1}{2}$ Buff on Rdway }		\$ 1.36
8	Ft. $\frac{3}{4}$ in. { Copper Galv. Iron } Pipe at		\$ 7.6
	Cast Iron }		
	Nipples .....in. at		\$
	Bushings .....to .....in. at		\$
	Red'g } Couplings.....to.....in. at		\$
	Inc'g }		
	Union.....in. at		\$
	Meter.....in. at		\$
	Lbs. Br. Stone at		\$
	Lbs. Sand at		\$
	Bags Cement at		\$
	Paving Brick { Mack Red Asphalt } at		\$
	Lead Joints at		\$
	Leadite Joints at		\$
	Hrs. Foreman at		\$ 1.88
	Hrs. <del>Common Labor</del> at <i>Tapper</i>		\$ 2.00
	Hrs. Common Labor at		\$ 3.50
	Hrs. Mason at		\$
	Hrs. Masons' Helper at		\$
	Hrs. Compressor at		\$
	Compensation Ins		\$ 1.23
	Trucking		\$ 1.00
	Builders Use of Water <i>Patrol</i>		\$ 2.50
	<b>Total</b>		<b>\$ 16.24</b>

33-70

Labor and Material Report Sept 9 1933

2 Lincoln Ave

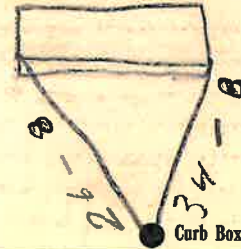

12 Main

Elev. of Main at tap 4

Gate at ●

● Gate at

● Curb Box

*Old Tap Shut off at  
Main*