

### LABOR AND MATERIALS

1	Copper	Connection	3/4		\$ 1.23
1	Curb	Cock Valve T. S. & V.	3/4 in.		\$ 1.68
1	Service Box	Old returned {	Short 3 1/2 x 4 1/2		\$ 1.75
			Long 4 1/2 x 5 1/2		
40	Ft.		3/4 in.	Copper Galv-Iron-Cast-Iron Pipe at	\$ 6.00
	Nipples	in. at			\$
	Bushings	to in. at			\$
	Red'g Inc'g	Couplings	to in. at		\$
	Union	in. at			\$
	Meter	in. at			\$
	Lead Joints	at			\$
	Leadite Joints	at			\$
	Hrs. Foreman	at			\$
2	Hrs. Chauffeur	at	6 2/4		\$ 1.25
3	Hrs. Tapper	at	1		\$ 1.88
18	Hrs. Labor	at	46		\$ 8.10
	Hrs. Labor	at			\$
1	Hrs. Compressor	at	9 7/8		\$ 98
	Compensation Ins.				\$ 35
	Trucking				\$ 1-
	Builders Use of Water	no pitz (B.P.)			\$
	Taylor Hassell				\$
					\$
					\$
					\$
					\$
					\$ 23.12


1 2 2 - 1938

St.  
Pt.  
Ave. No. 31

Lincoln

Name of Owner  
E. J. Mack

Labor and Mat'l. Report Aug 28 1938

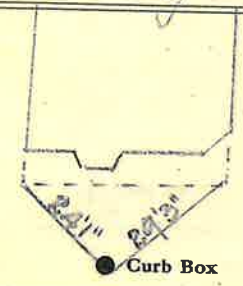

14 Main Elev. of Main at tap 4 1/2

Gate at ● Gate at ●

● Curb Box

old shut off