

LABOR AND MATERIALS

Copper } Connection	_____	\$	_____
Lead } }	_____	\$	_____
Curb } Cock	} in. _____	\$	_____
} Valve			
} T. S. & V.			
Service box } Short 3½ x 4½	} _____	\$	_____
Old returned } Long 4½ x 5½			
Ft. ¾ in. } Copper	} Pipe at _____	\$	_____
} G. I.			
} G. I.			
Nipples _____ in. at _____	\$	_____	
Bushings _____ to _____ in. at _____	\$	_____	
Red'g } Coupl'gs _____ to _____ in. at _____	\$	_____	
Inc'g }			
Union _____ in. at _____	\$	_____	
Meter _____ in. at _____	\$	_____	
_____	\$	_____	
Compound Joints at _____	\$	_____	
Maintenance Foreman _____	\$	_____	
Hrs. Water Maint. Man—1 at _____	\$	_____	
Hrs. Water Maint. Man—2 at _____	\$	_____	
Hrs. Garage Foreman _____ at _____	\$	_____	
Hrs. Labor— _____ at _____	\$	_____	
Hrs. Compressor at _____	\$	_____	
_____	\$	_____	
Trucking _____	\$	_____	
Pav't Patch _____	\$	_____	
_____	\$	_____	
_____	\$	_____	
_____	\$	_____	
_____	\$	_____	


Lincoln

Str. Pl. Ave. No. 36

Name of Owner

Labor and Mat'l. Report

19 90

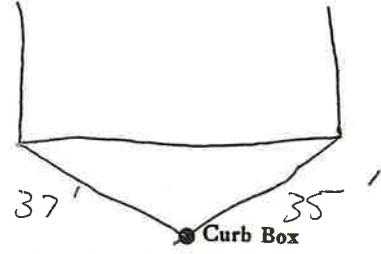

Main \_\_\_\_\_ Elev. of Main at tap \_\_\_\_\_

Gate at ● \_\_\_\_\_ Gate at \_\_\_\_\_

● Curb Box