

### Labor and Materials


1	Copper Lead	Connection	$\frac{3}{4}$	\$ 2.70
1	Curb Cock Valve T-S & V.		$\frac{3}{4}$	\$ 2.39
1	Service Box Old returned	Short $3\frac{1}{2} \times 4\frac{1}{2}$ Long $4\frac{1}{2} \times 5\frac{1}{2}$ Built on Rdway		\$ 1.45
39	Ft.	in.	Copper Cast Iron Pipe at	$\frac{3}{4}$ \$ 10.53
	Nipples	in. at		\$
	Bushings	to in. at		\$
	Red'g Inc'g	Couplings	to in. at	\$
	Union	in. at		\$
	Meter	in. at		\$
	Lbs. Br. Stone	at		\$
	Lbs. Sand	at		\$
	Bags Cement	at		\$
	Paving Brick	Mack Red Asphalt	at	\$
	Lead Joints	at		\$
	Leadite Joints	at		\$
6	Hrs. Foreman	at		\$ 3.75
22	Hrs. Common Labor	at		\$ 9.90
	Hrs. Common Labor	at		\$
	Hrs. Mason	at		\$
	Hrs. Mason's Helper	at		\$
	Hrs. Compressor	at		\$
	Compensation Ins			\$ 4.2
	Trucking			\$ 1.00
	Builders' Use of Water	Patch		\$ 5.00
Total \$				37.14

0-71

Labor and Material Report

July 2 1930

37 Lincoln Ave.

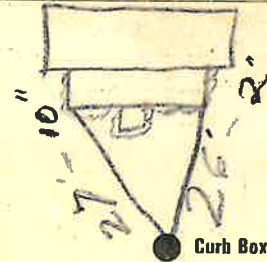

16 Main

Elev of  
Main at tap 4 1/2

Gate at ●

● Gate at

● Curb Box