

LABOR AND MATERIALS

1	Copper Lead	{ Connection $\frac{3}{4}$	-----	\$ 1.23
1	Curb	{ Cock Valve F. S. & V. } $\frac{3}{4}$ in.	-----	\$ 1.68
1	Service Box Old returned	{ Short $3\frac{1}{2} \times 4\frac{1}{2}$ Long $4\frac{1}{2} \times 5\frac{1}{2}$ Buff. or Rdway }	-----	\$ 1.75
13	Ft. $\frac{3}{4}$ in.	{ Copper Galv-Iron Cast-Iron } Pipe at	-----	\$ 1.95
-----	Nipples	in. at -----		\$ -----
-----	Bushings	to ----- in. at -----		\$ -----
-----	Red'g Inc'g	{ Couplings. to ----- in. at -----		\$ -----
-----	Union	in. at -----		\$ -----
-----	Meter	in. at -----		\$ -----
-----	Lead Joints	at -----		\$ -----
-----	Leadite Joints	at -----		\$ -----
-----	Hrs. Foreman	at -----		\$ -----
2	Hrs. Chauffeur	at $6\frac{1}{2}$	\$ 1.25	
3	Hrs. Tapper	at 7	\$ 1.88	
18	Hrs. Labor	at 45	\$ 8.10	
-----	Hrs. Labor	at -----		\$ -----
1	Hrs. Compressor	at $8\frac{1}{2}$	\$.88	
-----	Compensation Ins.		\$.35	
-----	Trucking		\$ 1.00	
-----	Builders Use of Water	Patch (B.P.)	\$ -----	
-----	Tup. by Messell		\$ -----	
-----			\$ -----	
-----			\$ -----	
-----			\$ -----	
-----			\$ -----	
				\$ 19.07

1 2 8 - 1938


St.
Pl.

Ave. No. 40

Name of Owner

Paul Koch

Labor and Mat'l. Report Aug 31 1938

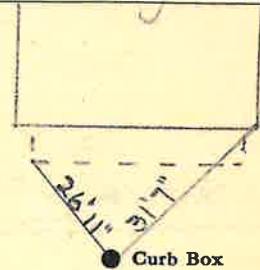

16 Main

Elev. of
Main at tap 4 1/2

Gate at ●

● Gate at

● Curb Box

off shot off