

Labor and Materials


3/4	Copper } Connection.....	\$ 3.20
1	Curb { Cock } 3/4 in.....	\$ 1.00
	{ Valve } { P.S. & V. }	
1	Service Box { Short 3 1/2 x 4 } Old returned { Long 4 1/2 x 5 } { Buff. or Relay }	\$ 1.30
31	Ft. 3/4 in. { Copper } Pipe at.....	\$ 68.27
	{ Galv. Iron }	
	{ Cast Iron }	
	Nipples..... in. at.....	\$
	Bushings..... to..... in. at.....	\$
	Red'g } Couplings..... to..... in. at.....	\$
	Inc'g }	
	Union..... in. at.....	\$
	Meter..... in. at.....	\$
	Lbs. Br. Stone at.....	\$
	Lbs. Sand at.....	\$
	Bags Cement at.....	\$
	Paving Brick { Mack } { Red } { Asphalt }	at..... \$
	Lead Joints at.....	\$
	Leadite Joints at.....	\$
2	Hrs. Foreman at.....	6 2/3 \$ 12.5
4	Hrs. Common Labor at.....	40 5/8 \$ 24.4
	Hrs. Common Labor at.....	\$
	Hrs. Mason at.....	\$
	Hrs. Mason's Helper at.....	\$
	Hrs. Compressor at.....	\$
	Compensation Ins.....	\$ 18
	Trucking.....	\$ 10.0
	Builders' Use of Water.....	\$
Total		\$ 171.9

Labor and Material Report

721 26

19 28

3/4 Top 43 Juncos Ave

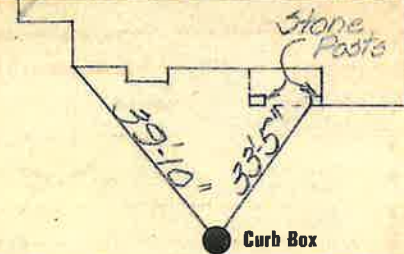

6" Main

Elev. of Main at tap 5'

Gate at 31' to MAIN

Gate at

● Curb Box

Curb stop is in on
Position when off.