

Labor and Materials

Copper	Connection	3	\$ 3 20
Lead		4	
Curb	Cock Valve	3	\$ 1 00
Service Box	Short 3/4 x 1/2		
Old returned	Long 1/2 x 3/4		\$ 1 30
	Burned Down		
Ft.	Copper Galv. Iron Pipe at		\$
	Cast Iron		
Nipples	in. at		\$
Bushings	to in. at		\$
Red'g	Couplings to in. at		\$
Inc'g			
Union	in. at		\$
Meter	in. at		\$
Lbs. Br. Stone	at		\$
Lbs. Sand	at		\$
Bags Cement	at		\$
Paving Brick	Mack Red Asphalt at		\$
Lead Joints	at		\$
Leadite Joints	at		\$
Hrs. Foreman	at	1.25	\$ 1 25
Hrs. Common Labor	at	2.25	\$ 2 25
Hrs. Common Labor	at		\$
Hrs. Mason	at		\$
Hrs. Mason's Helper	at		\$
Hrs. Compressor	at		\$
Compensation Ins		12	\$ 12
Trucking		1 00	\$ 1 00
Builders' Use of Water			\$


Total \$ 11.25

28-127

Labor and Material Report

24 1929

44 Lincoln

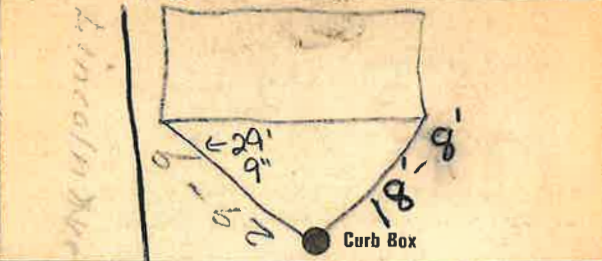

Garfield St
6 Main Elev of Main at tap 4 1/2

Gate at ● TAX ID # 302.19-5-10 ● Gate at

● Curb Box
New House
Tap on Garfield St