

# LABOR AND MATERIALS


1	Copper Lead	Connection	\$
1	Curb	1 1/4" Gate Valve in.	\$
1	Service box Old returned	Short 3 1/2 X 4 1/2 Long 4 1/2 X 5 1/2 Buff or Rdway	\$
30	3/4 in.	Pipe at	\$
		Nipples in. at	\$
		Bushings to in. at	\$
		Red'g Inc'g } Couplings to in. at	\$
		Union in. at	\$
		Meter in. at	\$
		Lead Joints at	\$
		Compound Joints at	\$
2	Hrs. Foreman at	\$	
	Hrs. Chauffeur at	\$	
	Hrs. Tapper at	\$	
18	Hrs. Labor at	\$	
	Hrs. Labor at	\$	
	Hrs. Compressor at	\$	
	Compensation Ins.	\$	
	Trucking 100	\$	
	Builders Use of Water	\$	
	Measure by this means	\$	
	This tap on Kensington Rd.	\$	
			\$ 25.06

St. Lincoln Ave. No. 45

Name of Owner  
TAX ID # 302.15-11-10

Remeasured 12-11-1945

Labor and Mat'l. Report Aug 1 1923

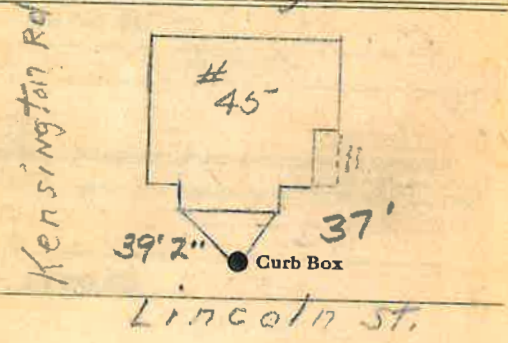

16" Main Elev. of Main at tap 3 1/2'

Gate at ● Gate at ●

Curb Box  
1 1/4" Gate Valve.  
with rod.