


**Labor and Materials**

1	Copper } Connection	3/4	\$ 3.20
	Lead }		
1	Curb { Cock } 3/4 in.		\$ 1.00
	{ Valve }		
	{ T. S. & V. }		
1	Service Box { Short 3 1/2 x 4 1/2 } 1/4		\$ 1.30
	Old returned { Long 4 1/2 x 5 1/2 } 1/4		
	{ Buff. or Rdway }		
2 3/4	Ft. 3/4 in. { Copper } Pipe at		\$ 5.06
	{ Galv. Iron }		
	{ Cast Iron }		
	Nipples..... in. at.....		\$
	Bushings..... to..... in. at.....		\$
1	Red'g } Couplings 3/4 to..... in. at.....		\$ 1.5
	inc'r }		
	Union..... in. at.....		\$
	Meter..... in. at.....		\$
	Lbs. Br. Stone at.....		\$
	Lbs. Sand at.....		\$
	Bags Cement at.....		\$
	Paving Brick { Mack } at.....		\$
	{ Red }		
	{ Asphalt }		
	Lead Joints at.....		\$
	Leadite Joints at.....		\$
	Hrs. Foreman at.....		\$
7	Hrs. Common Labor at <i>Frank George</i>	\$ 2.84	
7	Hrs. Common Labor at <i>Miller</i>	\$ 3.10	
	Hrs. Mason at.....		\$
	Hrs. Mason's Helper at.....		\$
	Hrs. Compressor at.....		\$
	Compensation Ins.....	\$ 1.17	
1	Trucking.....	\$ 1.00	
	Builders' Use of Water.....		\$
	<b>Total</b>	<b>\$ 18.22</b>	

*no 53 Lincoln Ave.*

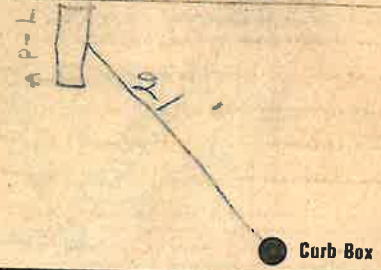

16" Main Elev. of Main at tap *5'*  
 Gate at ● ● Gate at

● Curb Box  
*new top*