


Labor and Material Report

1928

70 Lincoln Ave.

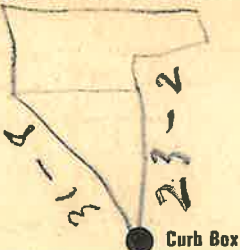

16 Main

Elev of Main at tap

42

Gate at ●

● Gate at

● Curb Box

New house.

Labor and Materials

Copper	Connection	3	\$	3.20
Curb	Cock Valve T. S. & V.	1	in.	3/4
Service Box	Short 3/4 x 1/2	1		
Old returned	Long 1/2 x 5/8	1		
	Buff. or Rdway			
4	Ft. in.	3	Pipe at	9.02
	Nipples	4	in. at	
	Bushings		to in. at	
	Red'g Inc'g		Couplings to in. at	
	Union		in. at	
	Meter		in. at	
	Lbs. Br. Stone		at	
	Lbs. Sand		at	
	Bags Cement		at	
	Paving Brick		Mack Red Asphalt at	
	Lead Joints		at	
	Leadite Joints		at	
4	Hrs. Foreman		at	2.50
8	Hrs. Common Labor		at	3.25
	Hrs. Common Labor		at	
	Hrs. Mason		at	
	Hrs. Mason's Helper		at	
	Hrs. Compressor		at	
	Compensation Ins			15
	Trucking			1.00
	Builders' Use of Water			

Total \$ 21.42