

Labor and Materials


1 Copper Lead { Connection.....	3 3/4	\$	1.46
1 Curb { Crock Valve }	3	\$	1.93
		T-S-&-V	
1 Service Box { Short 3 1/2 x 4 1/2 }		\$	1.77
Old returned { Long 4 1/2 x 5 1/2 }		\$	
		Buff. or Rdway	
7 Ft. in. { Copper Galv-Iron Cast-Iron } Pipe at	3 1/2	\$	1.54
Nipples	in. at	\$	
Bushings	to in. at	\$	
Red'g Inc'g { Conplings..... to	in. at	\$	
Union	in. at	\$	
Meter	in. at	\$	
Lead Joints at		\$	
Leadite Joints at		\$	
4 Hrs. Foreman at		\$	
Hrs. Chauffeur at	6 1/2 hr	\$	2.50
Hrs. Tapper at		\$	
9 Hrs. Labor at	4.5	\$	4.05
Hrs. Labor at		\$	
Hrs. Compressor at		\$	
Compensation Ins.		\$	2.00
Trucking		\$	1.00
Builders Use of Water	Patch	\$	5.00
Tap by Purv		\$	
		\$	19.45

114-1937

-St.
Pl.
Ave. No. 4

Name of Owner
Gentry

Labor and Mat'l. Report Oct 23 1937

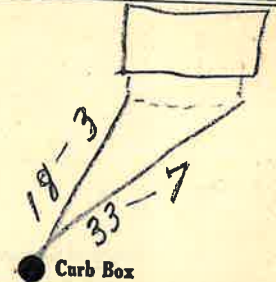

16 Main Elev. of Main at tap 4
 Gate at ● Gate at ●

● Curb Box

old shot off

3/4" **LABOR AND MATERIALS**

Copper } Connection _____ \$ _____
 Lead }
 Curb } Cock Valve } _____ in. \$ _____
 } T.S. & V. }


Service Box } Short 3-1/2 x 4-1/2 } _____ \$ _____
 Old returned } Long 4-1/2 x 5-1/2 }

Ft. _____ in. { Copper } Pipe at _____ \$ _____
 { G.I. }
 { C.I. }

Nipples _____ in. at _____ \$ _____
 Bushings _____ to _____ in. at _____ \$ _____
 Red'g _____
 Inc'g _____
 Union _____ in. at _____ \$ _____
 Meter _____ in. at _____ \$ _____
 _____ \$ _____
 Compound Joints at _____ \$ _____
 Maintenance Foreman _____ \$ _____
 Hrs. Water Maint. Man - 1 at _____ \$ _____
 Hrs. Water Maint. Man - 2 at _____ \$ _____
 Hrs. Garage Foreman _____ at _____ \$ _____
 Hrs. Labor _____ at _____ \$ _____
 Hrs. Compressor at _____ \$ _____
 _____ \$ _____
 _____ \$ _____
 Trucking _____ \$ _____
 Pav't Patch _____ \$ _____
 _____ \$ _____
 _____ \$ _____
 _____ \$ _____
 _____ \$ _____

Lincoln St. *Lincoln*
 Pl. Ave. No. *4*
 Name of Owner _____

Labor and Mat'l. Report 19 *2-12-15*

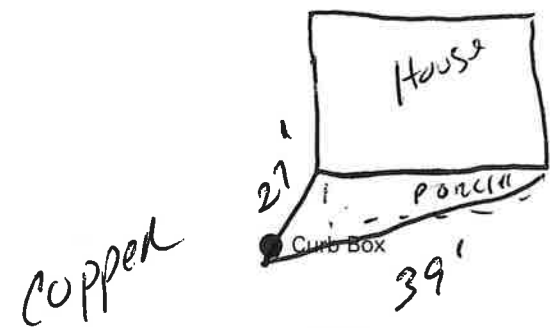

_____ Main Elev. of Main at tap _____
 Gate at ● Gate at ●

● Curb Box