


Labor and Materials

1	Copper	Connection	$\frac{3}{4}$	\$ 2.60
1	Curb	Cock Valve T. S. & V.	$\frac{3}{4}$	\$ 2.30
1	Service Box	Short $3\frac{1}{2} \times 4\frac{1}{2}$		\$ 1.40
	Old returned	Long 11 x 5 Bottom of Redway		
39	Ft.	Copper Galv. Iron Cast Iron	Pipe at $\frac{3}{4}$	\$ 10.34
	Nipples	in. at		\$
1	Bushings	$\frac{1}{2}$ to $\frac{3}{4}$ in. at		\$ 1.0
	Red'g Inc'g	Couplings	to in. at	\$
	Union	in. at		\$
	Meter	in. at		\$
	Lbs. Br. Stone	at		\$
	Lbs. Sand	at		\$
	Bags Cement	at		\$
	Paving Brick	Mack Red Asphalt at		\$
	Lead Joints	at		\$
	Leadite Joints	at		\$
1	Hrs. Foreman	at		\$ 2.13
32	Hrs. Common Labor	at		\$ 3.00
	Hrs. Common Labor	at		\$
	Hrs. Mason	at		\$
	Hrs. Mason's Helper	at		\$
	Hrs. Compressor	at		\$
	Compensation Ins			\$ 43
	Trucking			\$ 1.00
	Builders' Use of Water	Patch		\$ 5.00
Total				\$ 39.30

Labor and Material Report

May 3 1929

5 Lincoln St.

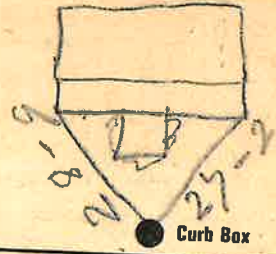

16 Main Elev of Main at tap 4 1/2

Gate at ● Gate at ●

● Curb Box

old Tap had to be
tied up No Charge
3 Hours