


LABOR AND MATERIALS

Copper	} Connection		\$
Lead			
Curb	{ Clock Valve T. S. & V. } in.	\$
Service box		{ Short 3½X4½ Long 4½X5½ Buff or Rdway }	
Old returned			
Ft. in.	{ Copper Galv. Iron Cast Iron }		Pipe at
Nipples in. at		\$
Bushings to	in. at	\$
Red'g Inc'g	} Couplings to	\$
Union	 in. at	\$
Meter in. at		\$
Lead Joints	at		\$
Compound Joints	at		\$
Hrs. Foreman	at		\$
Hrs. Chauffeur	at		\$
Hrs. Tapper	at		\$
Hrs. Labor	at		\$
Hrs. Labor	at		\$
Hrs. Compressor	at		\$
Compensation	Ins.		\$
Trucking			\$
Builders Use of Water			\$
<i>Measured by M. J. ...</i>			
			\$
			\$
St. Locust
 Pl. 10
 Ave. No. 10

Name of Owner _____

Labor and Mat'l. Report Dec 11 1945

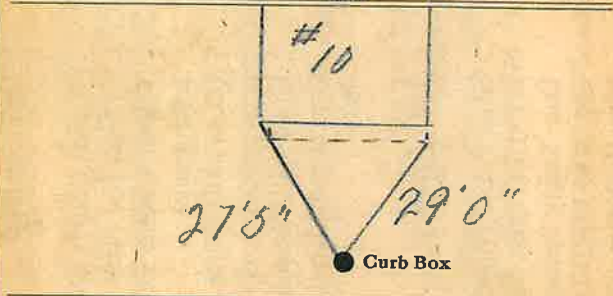

..... Main Elev. of Main at tap.....

Gate at ● ● Gate at

● Curb Box