


LABOR AND MATERIALS

Copper	} Connection	_____	\$ _____	
Lead				
Curb	} Cock } Valve } T. S. & V. }	_____ in.	\$ _____	
Service box		{ Short 3½ x 4½ } Long 4½ x 5½ } Buff or Rdway }	_____	\$ _____
Old returned				
22 Ft. ¾ in.	{ Copper } G.I. } C.I. }		Pipe at _____	\$ _____
Nipples	in. at _____		\$ _____	
Bushings	to _____ in. at _____		\$ _____	
Red'g } Ine'g }	Coupl'gs	to _____ in. at _____	\$ _____	
Union	in. at _____		\$ _____	
Meter	in. at _____		\$ _____	
Lead Joints	at _____		\$ _____	
Compound Joints	at _____		\$ _____	
Maintenance Foreman			\$ _____	
Hrs. Water Maint. Man—1	at _____		\$ _____	
Hrs. Water Maint. Man—2	at _____		\$ _____	
Hrs. Garage Foreman	at _____		\$ _____	
Hrs. Labor—	at _____		\$ _____	
Hrs. Compressor	at _____		\$ _____	
Compensation Ins. at \$ _____	per C _____		\$ _____	
Trucking			\$ _____	
Pav't Patch			\$ _____	
			\$ _____	
			\$ _____	
O'head			\$ _____	
			\$ _____	

St.
PL
Ave. No. 14

Locust
Name of Owner _____

Labor and Mat'l. Report 19

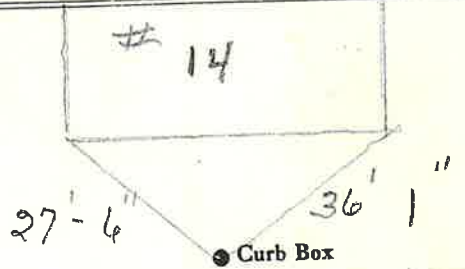

Main Elev. of
Main at tap _____

Gate at ● ● Gate at _____

● Curb Box