

Labor and Materials


1	Copper	Connection	3/4"	\$
	Lead			
same	Curb	Cock Valve	3/4" in	\$
		T. S. & V.		
same	Service Box - Old returned	Short 3 1/2 x 4 1/2	}	\$
		Long 4 1/2 x 5 1/2		
2'	Rest	Buff. or Rdway	?	\$
		Copper	}	\$
		Galv Iron		
		Cast Iron		
	Nipples	in. at		\$
	Bushings	to in. at		\$
	Red'g Inc'g	Conplings to in. at		\$
	Union	in. at		\$
	Meter	in. at		\$
	Lead Joints	at		\$
	Leadite Joints	at		\$
	Hrs. Foreman	at		\$
	Hrs. Chauffeur	at		\$
	Hrs. Tapper	at		\$
	Hrs. Labor	at		\$
	Hrs. Labor	at		\$
	Hrs. Compressor	at		\$
	Compensation Ins.			\$
	Trucking			\$
	Builders Use of Water			\$

2' - 3/4" K Copper \$
 at main Rest of
 Service Galv. Iron,
 1960

St. **27**
 Pl.
 Ave. No. **21**

Name of Owner
 TAX ID # 302.16-4-18

Labor and Mat'l. Report 19

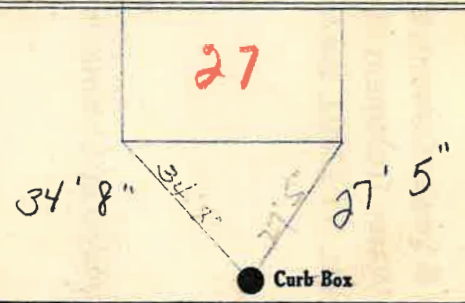

6" 1960 Main Elev. of Main at top 5'

Gate at ● ● Gate at

● Curb Box