

LABOR AND MATERIALS


Copper	}	Connection.....	\$	
Lead				
Curb	{	Cock Valve T. S. & V. }	in.	\$
Service Box Old returned	{	Short 3 $\frac{1}{2}$ x4 $\frac{1}{2}$ Long 4 $\frac{1}{2}$ x5 $\frac{1}{2}$ Buffer Rdway }		\$
Ft.	{	Copper Galv Iron Cast Iron } Pipe at	in.	\$
Nipples		in. at		\$
Bushings		to in. at		\$
Red'g Inc'g } Couplings		to in. at		\$
Union		in. at		\$
Meter		in. at		\$
Lead Joints at				\$
Leadite Joints at				\$
Hrs. Foreman at				\$
Hrs. Chauffeur at				\$
Hrs. Tapper at				\$
Hrs. Labor at				\$
Hrs. Labor at				\$
Hrs. Compressor at				\$
Compensation Ins.				\$
Trucking				\$
Builders Use of Water				\$
				\$
				\$
				\$
				\$

St. 18
Pl. 2
Ave. No. 2

Logan

Name of Owner

Labor and Mat'l. Report SEP 7 [?] 1939 19

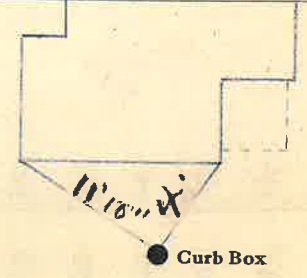

2" Main *Ash Ave.* Elev. of Main at tap

Gate at ● Gate at ●

● Curb Box

Also known as 11 Ash Ave.
5