

LABOR AND MATERIALS

1 Copper } Connection	1/2 x 3/4	\$ 1.35
1 Lead }		
1 Curb } Cock Valve F.S. & V.	3/4 in.	\$ 1.80
1 Service Box Old returned	Short 3 1/2 x 4 3/4 } Long 4 1/2 x 5 1/2 } Buffer Rdway	\$ 1.70
18 Ft. 3/4 in.	{ Copper } { Galv Iron } { Cast Iron }	Pipe at 18 \$ 3.24
Nipples	in. at	\$
Bushings	to in. at	\$
Red'g Inc'g } Couplings	to in. at	\$
Union	in. at	\$
Meter	in. at	\$
Lead Joints at		\$
Leadite Joints at		\$
Hrs. Foreman at		\$
4 Hrs. Chauffeur at	6 1/2 hr	\$ 2.50
Hrs. Tapper at		\$
16 Hrs. Labor at	45	\$ 7.20
Hrs. Labor at		\$
Hrs. Compressor at		\$
Compensation Ins.		\$.30
Trucking		\$ 1.00
Builders Use of Water	Patch	\$ 5.00
Taps by Miller		\$
		\$
		\$
		\$ 24.09

19 1941

22 A-13

St. _____
Pl. _____
Ave. No. 8


Hagan

Name of Owner

Rozelle

Labor and Mat'l. Report

Apr 24 1941

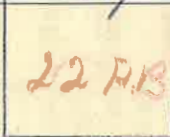

6" - 1960

Gal
Main

Elev. of Main at tap 7

Gate at ●

● Gate at

TAX ID # 302.16-3-2

● Curb Box