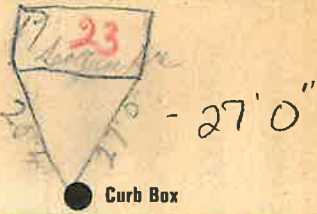


Labor and Materials

1	Copper	Connection	3/4"	\$ 2.60
1	Lead			
1	Curb	Cock Valve	3/4" in.	\$ 2.30
		T-S. & V.		
1	Service Box	Short 3/4"x1 1/2"		\$ 1.50
	Old returned	Long 4 1/2"x5 1/2"		
		Bull. or Rdway		
5 1/2	Pt.	3/4" in.	Copper Galv. Iron Pipe at	\$ 1.47
	Nipples	in. at	Cast Iron	\$
	Bushings	to in. at		\$
	Red'g Inc'g	Couplings	to in. at	\$
	Union	in. at		\$
	Meter	in. at		\$
	Lbs. Br. Stone	at		\$
	Lbs. Sand	at		\$
	Bags Cement	at		\$
	Paving Brick	Mack Red Asphalt	at	\$
	Lead Joints	at		\$
	Leadite Joints	at		\$
6	Hrs. Foreman	at		\$ 3.75
8	Hrs. Common Labor	at		\$ 3.25
	Hrs. Common Labor	at		\$
	Hrs. Mason	at		\$
	Hrs. Mason's Helper	at		\$
	Hrs. Compressor	at		\$
	Compensation Ins.			\$ 1.19
	Trucking			\$ 1.00
	Builders' Use of Water	Patch		\$ 5.00
Total \$				21.06

29-155 23 1929
Labor and Material Report
 17 Logan Ave.

 6" - 1960
 Main Elev of Main at tap 44.2
 Gate at ● TAX ID # 302.16-4-20 ● Gate at
 ● Curb Box
 New top
 Old top to dig up on adjacent