


LABOR AND MATERIALS

1	Copper Lead	} Connection	3/4"	\$
1	Curb			
1	Service box Old returned	} Short 3 1/2 x 4 1/2 Long 4 1/2 x 5 1/2 Buf. or Rdway		\$
21	Ft. 3/4 in.			
	Nipples	in. at	\$	
	Bushings	to in. at	\$	
	Red'g } Inc'g	Coupl'gs. to in. at	\$	
	Union	in. at	\$	
	Meter	in. at	\$	
	Lead Joints	at	\$	
	Compound Joints	at	\$	
	Maintenance Foreman		\$	
	Hrs. Water Maint. Man-1	at	\$	
	Hrs. Water Maint. Man-2	at	\$	
	Hrs. Garage Foreman	at	\$	
	Hrs. Labor	at	\$	
	Hrs. Compressor	at	\$	
	Compensation Ins. at \$	per C	\$	
	Trucking		\$	
	Pav't Patch		\$	
	Tap by Gissard & Co. 7-60			\$
	O'head		\$	

St. \_\_\_\_\_  
Pl. \_\_\_\_\_  
Ave. No. 75

Name of Owner \_\_\_\_\_

Labor and Mat'l. Report July 22 19 60

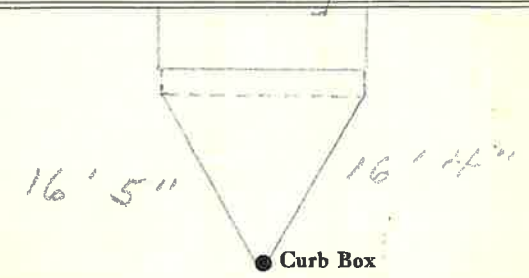

6" Main Elev. of Main at tap 5"

Gate at • Gate at

• Curb Box