

LABOR AND MATERIALS

1	Copper	Connection	3/4		\$	2.94
1	Lead	Cock				
1	Curb	Valve	3/4	in.	\$	3.71
		T. S. & V.				
1	Service box	Short 3 1/2 X 4 1/2			\$	5.90
	Old returned	Long 4 1/2 X 5 1/2				
		Buff or Rdway			\$	
25	Ft. 3/4	Copper		Pipe at	30	\$ 7.50
	Nipples	in. at			\$	
	Bushings	to in. at			\$	
	Red'g					
	Inc'g	Coupl'gs to in. at			\$	
	Union	in. at			\$	
	Meter	in. at			\$	
	Lead Joints at				\$	
	Compound Joints at				\$	
	Hrs. Water Maint. Man-1 at				\$	
6	Hrs. Water Maint. Man-2 at	91		\$	54.6	
14	Hrs. Labor at	80		\$	11.20	16.6
	Hrs. Labor at			\$		
	Hrs. Compressor at			\$		
	Compensation Ins. at \$		per C	\$	3.7	
	Trucking			\$	1.00	
	Pav't Patch			\$		
	<i>Topy Warsinske</i>			\$		
				\$		
				\$		
	O'head			\$		
				\$		

47

25


McOthar Drive

St. Pl. Ave. No. 4776

Name of Owner

By man

Labor and Mat'l. Report July 14 1948

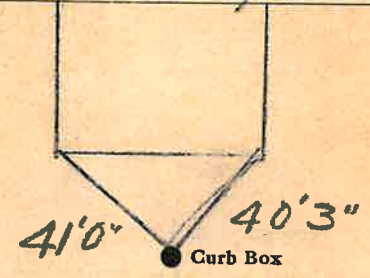

12 Main

Elev. of Main at tap 5

Gate at ●

● Gate at

● Curb Box