

LABOR AND MATERIALS

1	Copper Lead	Connection	3/4	\$	2.41
1	Curb	Cock Valve T.S. & V.	3/4 in.	\$	3.41
1	Service box	Short 3 1/2 x 4 1/2 Long 4 1/2 x 5 1/2 Buff or Rdway		\$	4.18
	Old returned				
32	Ft.	Copper Pipe	3/4 in.	\$	12.80
			40		
	Nipples	in. at		\$	
	Bushings	to in. at		\$	
	Red'g	Coupl'gs	to in. at	\$	
	Inc'g				
	Union	in. at		\$	
	Meter	in. at		\$	
	Lead Joints	at		\$	
	Compound Joints	at		\$	
	Maintenance Foreman			\$	
	Hrs. Water Maint. Man	1 at		\$	
7	Hrs. Water Maint. Man	2 at	1.24	\$	8.68
	Hrs. Garage Foreman	at		\$	
14	Hrs. Labor	at	1.13	\$	15.82
	Hrs. Compressor	at		\$	
	Compensation Ins.	at \$38.1 per C		\$	9.5
	Trucking			\$	1.50
	Pav't Patch			\$	13.50
	Tap by Gifford	12-6-54		\$	
	O'head			\$	
				\$	49.75
				\$	63.25


100-54

MacArthur Dr. ^{St.} Ave. No. ^{Pl.} 27

Name of Owner

Alton Bartholomew

Labor and Mat'l. Report Dec. 6 1954

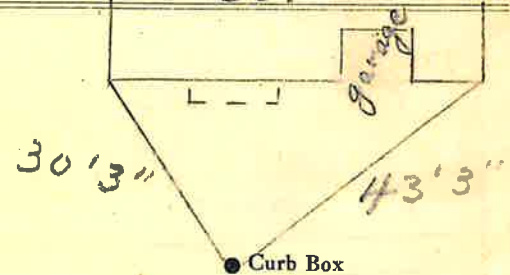

12" Main Elev. of Main at tap 5'

Gate at • Gate at •

• Curb Box

Tap on MacArthur Dr.