

LABOR AND MATERIALS

1	Copper	{ Connection	3/4"	\$	2.29
1	Lead	{ Cock			
1	Curb	{ Valve	3/4" in.	\$	2.70
		{ T.S. & V.			
1	Service box	{ Short	3 1/2 x 4 1/2		
	Old returned	{ Long	4 1/2 x 5 1/2		
		{ Buff or Rdway		\$	4.25
11	Ft.	{ Copper			
	3/4 in.	{ G.I.	Pipe at 35	\$	3.85
		{ G.I.			
	Nipples	in. at		\$	
	Bushings	to in. at		\$	
	Red'g	{ Coupl'gs	to in. at	\$	
	Inc'g				
	Union	in. at		\$	
	Meter	in. at		\$	
	Lead Joints at			\$	
	Compound Joints at			\$	
	Hrs. Water Maint. Man-1 at			\$	
3	Hrs. Water Maint. Man-2 at	1.02		\$	3.06
70	Hrs. Labor	at 91		\$	18.20
	Hrs. Labor	at		\$	
	Hrs. Compressor at			\$	
	Compensation Ins. at \$ 2.226 per C.			\$.47
	Trucking			\$	1.00
	Pav't Patch			\$	8.10
	Tap by Moquin			\$	
	O'head			\$	
				\$	43.72

21.00


199-1950

St. 30
Pl. Ave. No. 26

MacArthur Drv.

Name of Owner
De Graff

Labor and Mat'l. Report Oct 5 19 50

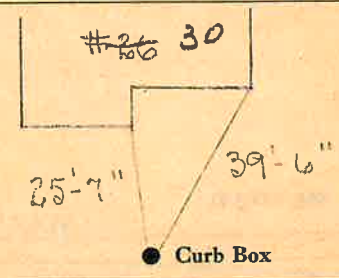

12" Main Elev. of Main at tap 5'
Gate at ● Gate at ●

● Curb Box